JOB No. 8373 ~ A6069

SUFFOLK COUNTY TAX MAP

DISTRICT	0904
SECTION	02.00
BLOCK	01.00
PARCEL	028.001

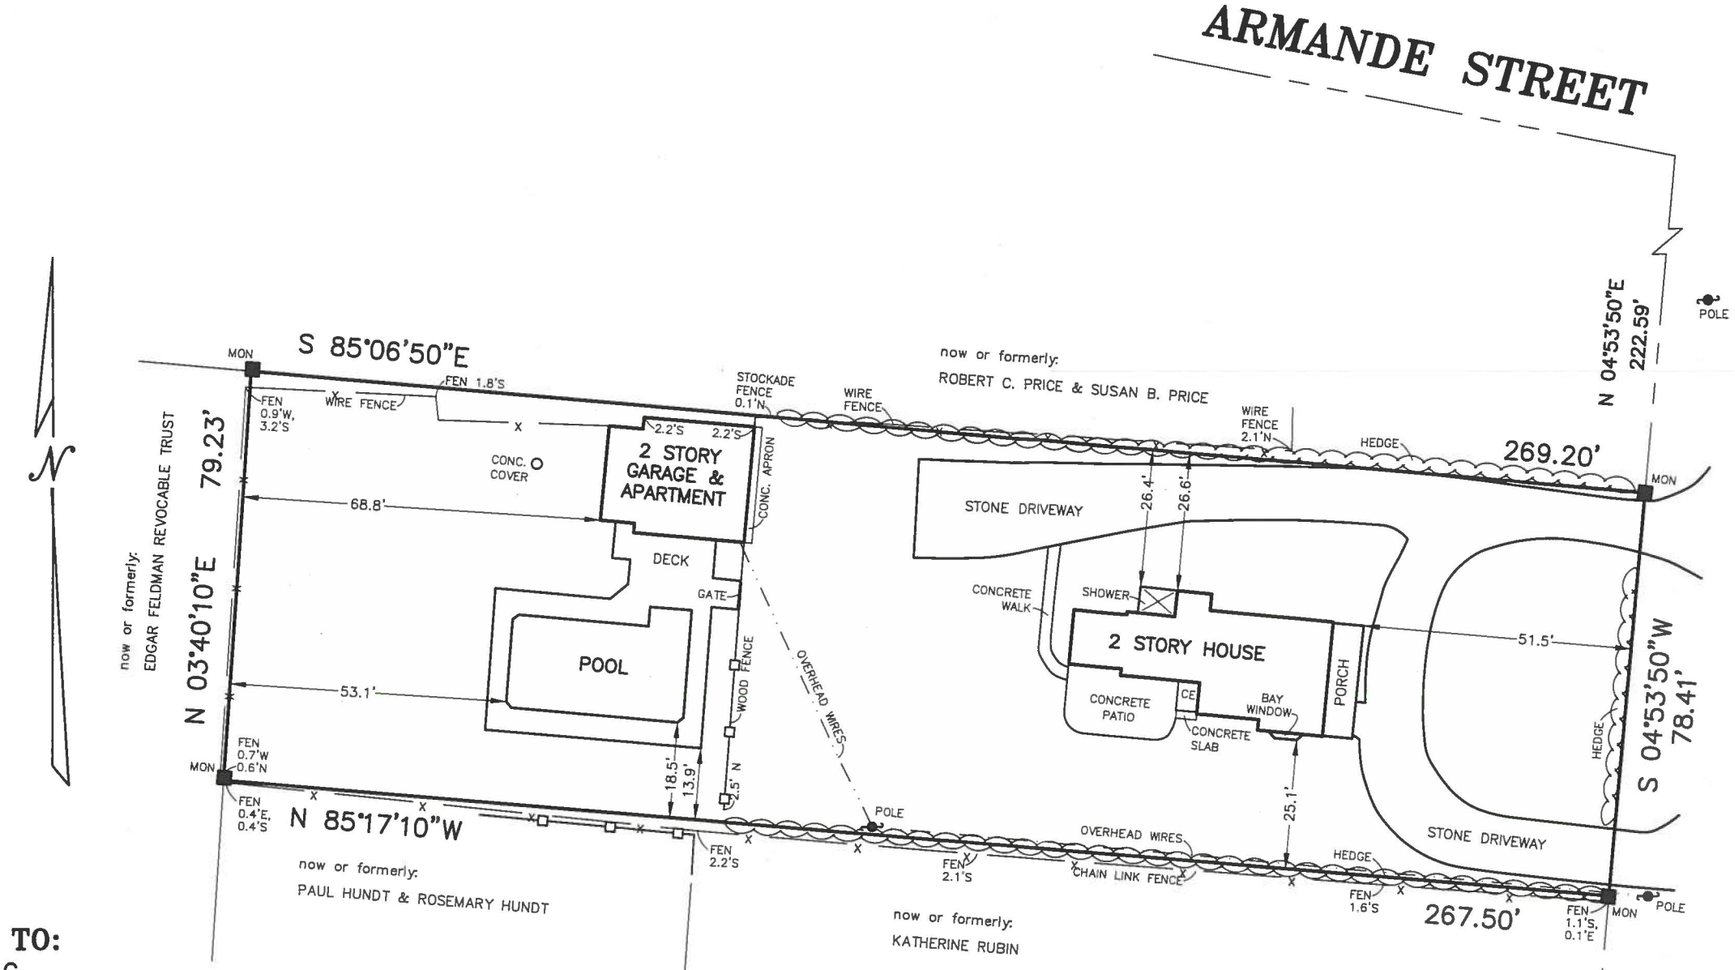

CERTIFIED TO:
89 HALSEY LLC
CITIBANK, N.A.
FIDELITY NATIONAL TITLE INSURANCE COMPANY

SURVEYED: APRIL 17, 2015

PROFESSIONAL LAND SURVEYOR
ROBERT A. SMITH
LIC. No. 49239
State of New York

ROBERT A. SMITH, L.S. 49239
S. H. W. and S., LAND SURVEYORS P.C.

SQUIRES, HOLDEN, WEISENBACHER & SMITH
LAND SURVEYING ~ LAND PLANNING ~ ENGINEERING
SOUTHAMPTON ~ NEW YORK

UNAUTHORIZED ALTERATION OR ADDITION TO A SURVEY MAP BEARING A LICENSED LAND SURVEYOR'S SEAL IS A VIOLATION OF SECTION 7209, SUB-DIVISION 2, OF THE NEW YORK EDUCATION LAW.
COPIES OF THIS SURVEY MAP NOT BEARING THE LAND SURVEYOR'S GREEN INKED SEAL OR EMBOSSED SEAL SHALL NOT BE CONSIDERED TO BE A VALID TRUE COPY.
CERTIFICATIONS INDICATED HEREON SIGNIFY THAT THIS SURVEY WAS PREPARED IN ACCORDANCE WITH THE EXISTING CODE OF PRACTICE FOR LAND SURVEYS ADOPTED BY THE NEW YORK STATE ASSOCIATION OF PROFESSIONAL LAND SURVEYORS. SAID CERTIFICATIONS SHALL RUN ONLY TO THE PERSON FOR WHOM THE SURVEY IS PREPARED, AND ON HIS BEHALF TO THE TITLE COMPANY, GOVERNMENTAL AGENCY AND LENDING INSTITUTION LISTED HEREON, AND TO THE ASSIGNEE'S OF THE LENDING INSTITUTION. CERTIFICATIONS ARE NOT TRANSFERABLE TO ADDITIONAL INSTITUTIONS OR SUBSEQUENT OWNERS.

MAP OF PROPERTY
FOR
89 HALSEY LLC
SITUATE
INC. VILLAGE OF SOUTHAMPTON
TOWN OF SOUTHAMPTON
SUFFOLK COUNTY, NEW YORK

AREA = 21,149 S.F. (0.486 ACRE)
SCALE: 1" = 30'

8373.dwg B 899 P 111–114 B 542 P 122 B 523 8+,154