

716A-136
1097-44
1117-10
514-124

DC14102
K251


MAP OF PROPERTY

AKA PARCEL NO. 2 OF THE UNFILED
SUBDIVISION OF F.S. BEEBE

SITUATE
MONTAUK

Town Of East Hampton, Suffolk Co., N.Y.
Scale: 1"=50'
Area: 73,478 S.F. or 1.687 Acres To M.H.W.
Lot Area: 37,057 S.F. or 0.851 Acres To Toe Of Bluff

Certified To:
Nicholas D. Pisto

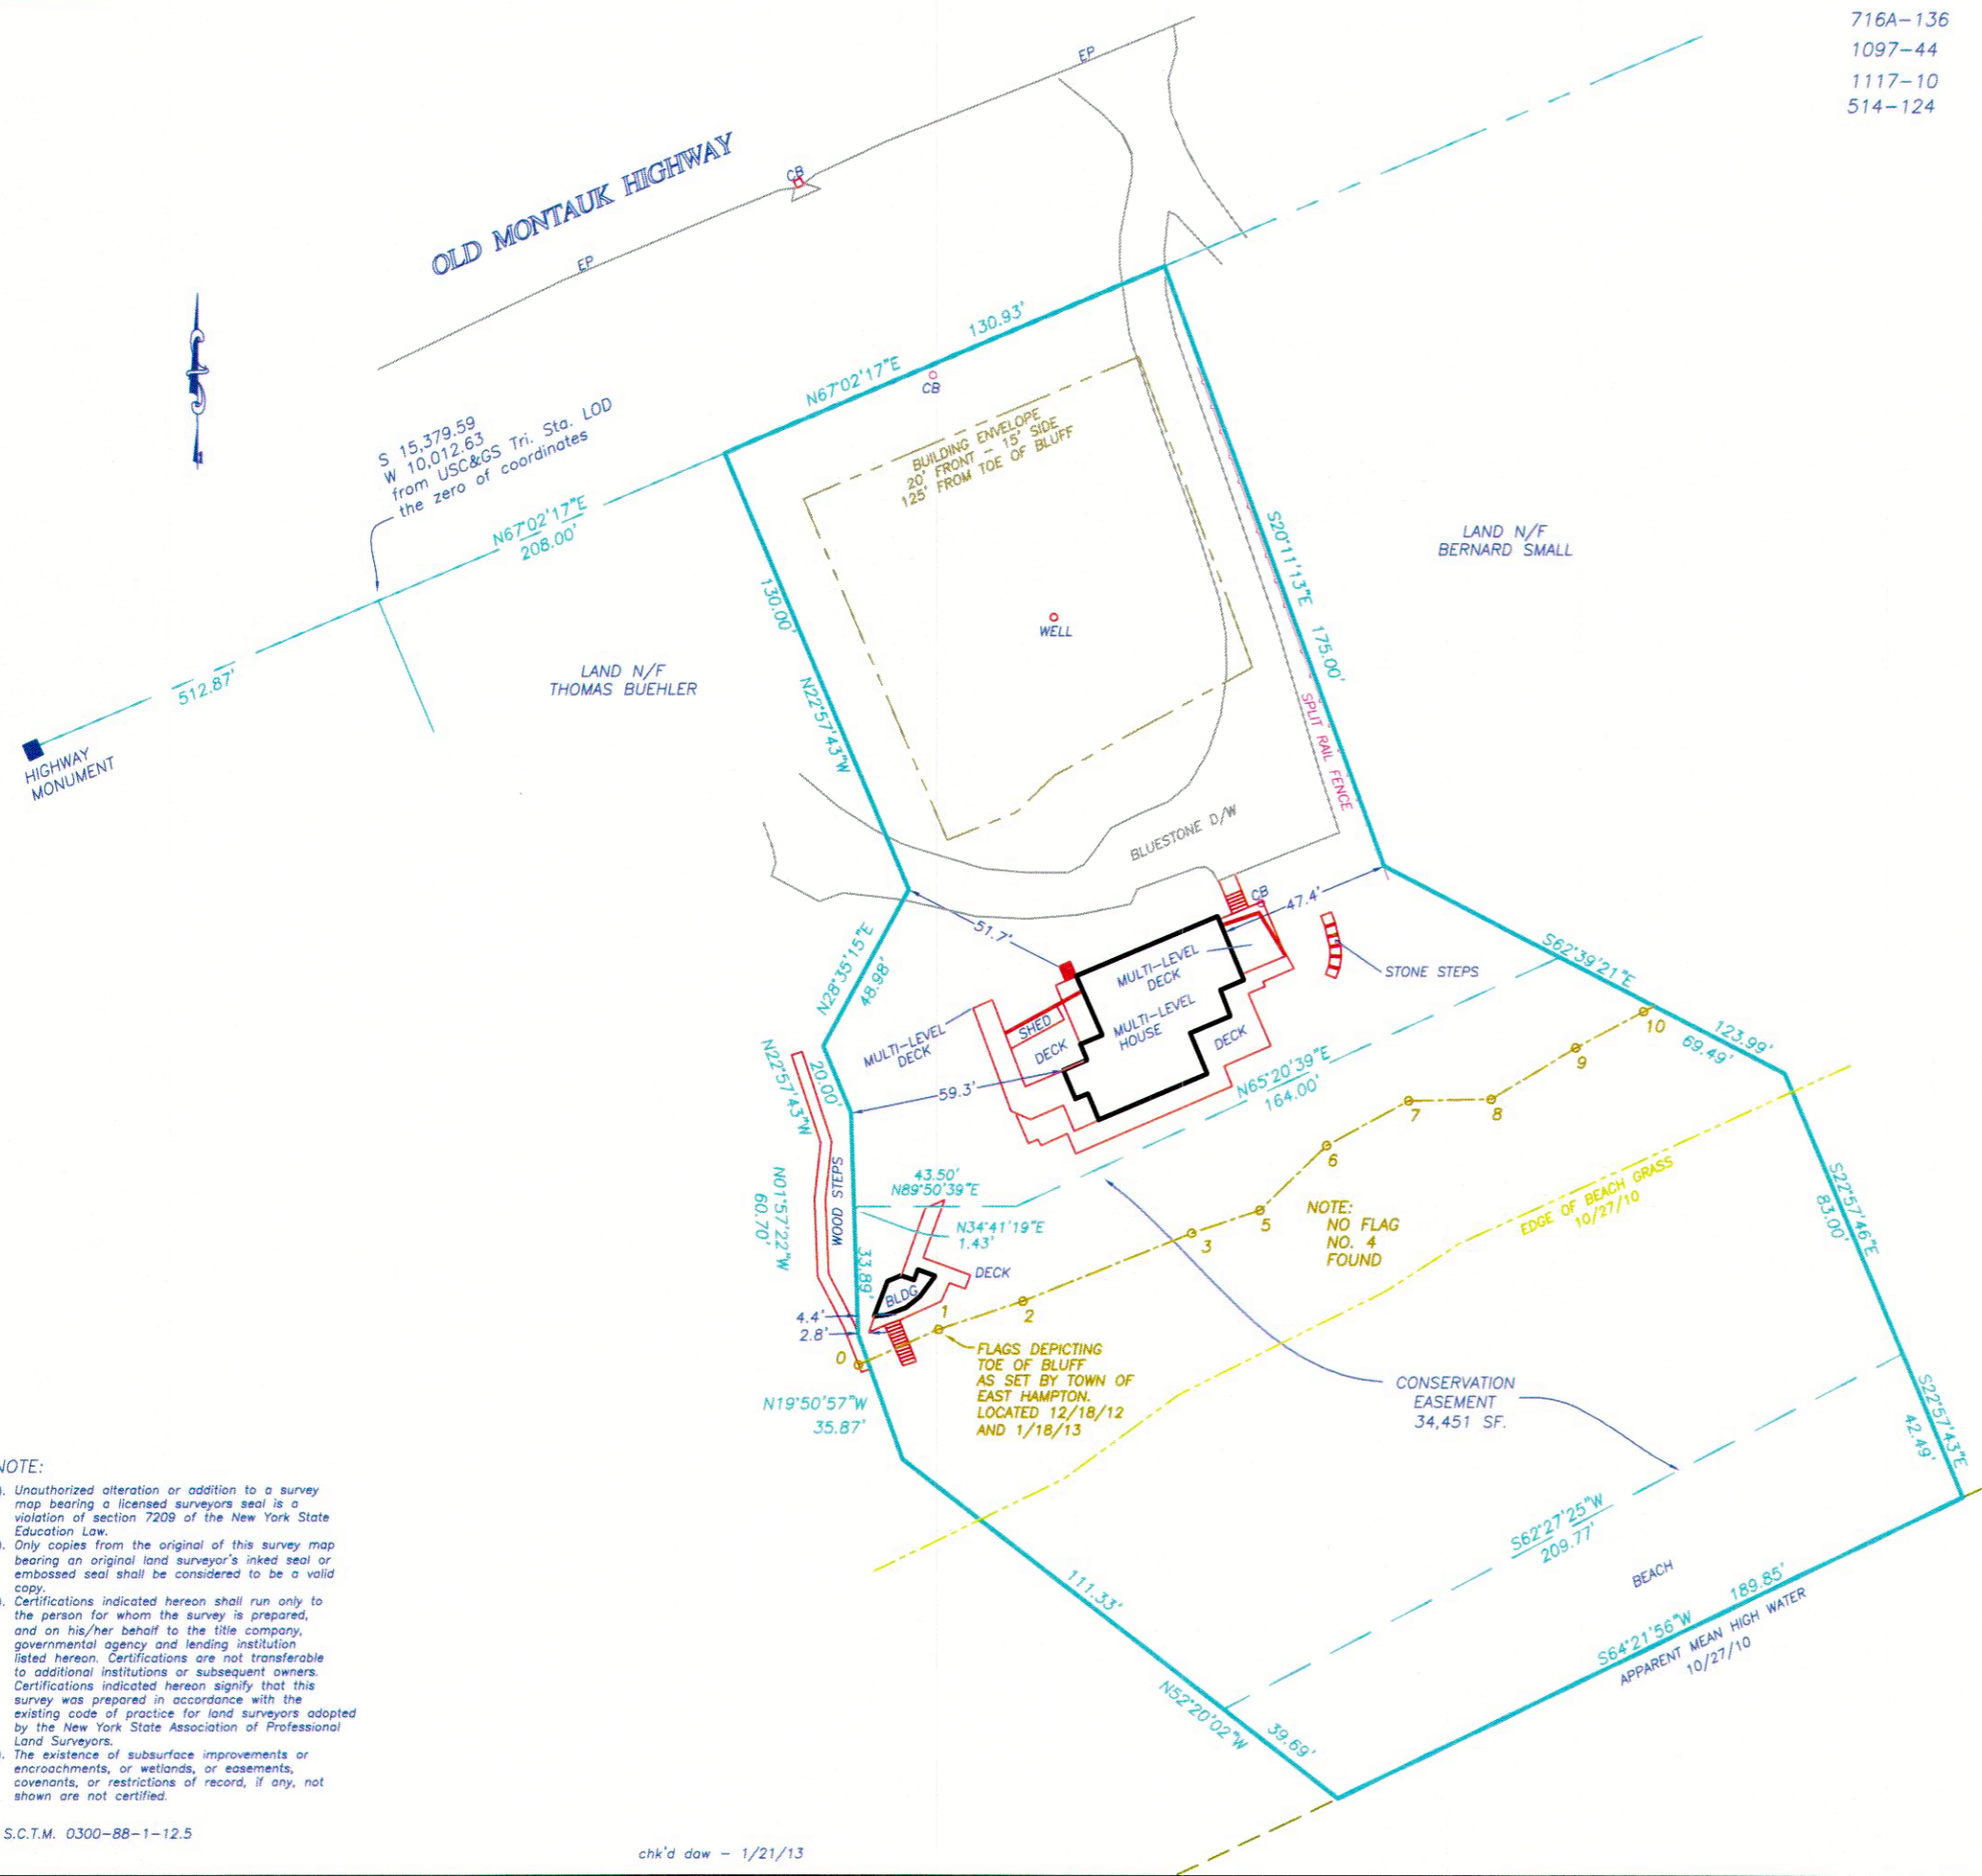

- NOTE:
- 1). Unauthorized alteration or addition to a survey map bearing a licensed surveyors seal is a violation of section 7209 of the New York State Education Law.
 - 2). Only copies from the original of this survey map bearing an original land surveyor's inked seal or embossed seal shall be considered to be a valid copy.
 - 3). Certifications indicated hereon shall run only to the person for whom the survey is prepared, and on his/her behalf to the title company, governmental agency and lending institution listed hereon. Certifications are not transferable to additional institutions or subsequent owners. Certifications indicated hereon signify that this survey was prepared in accordance with the existing code of practice for land surveyors adopted by the New York State Association of Professional Land Surveyors.
 - 4). The existence of subsurface improvements or encroachments, or wetlands, or easements, covenants, or restrictions of record, if any, not shown are not certified.

Revised: Jan. 18, 2013 - Add'l Bluff Flags
Revised: Dec. 18, 2012 - Toe of Bluff
Revised: November 8, 2010 (Update)
Surveyed: May 6, 1986

GEORGE WALBRIDGE SURVEYORS, P.C.
Land Surveyors & Land Planners
300 Pantigo Place - Suite 116
East Hampton, Long Island, N.Y. 11937
Phone: (631) 324-0412 Fax: (631) 324-9849
E-mail: ehsurveyor@aol.com

S.C.T.M. 0300-88-1-12.5

chk'd daw - 1/21/13

c:\land projects dave\Pisto\dwg\survey_1-18-13

DC14102