

SURVEY OF PROPERTY

LOT 57

Map of


NORTH HAVEN HILLS

Filed May 14, 1980 as map no. 6901

Situate
INCORPORATED VILLAGE OF NORTH HAVEN
Town Of Southampton
Suffolk County, New York


SCALE: 1" = 50'

AREA: 80,079 sq. ft.
or 1.8384 acres

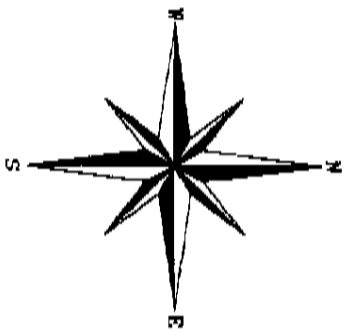

SCTM No. 901-002-4-41

801p8096

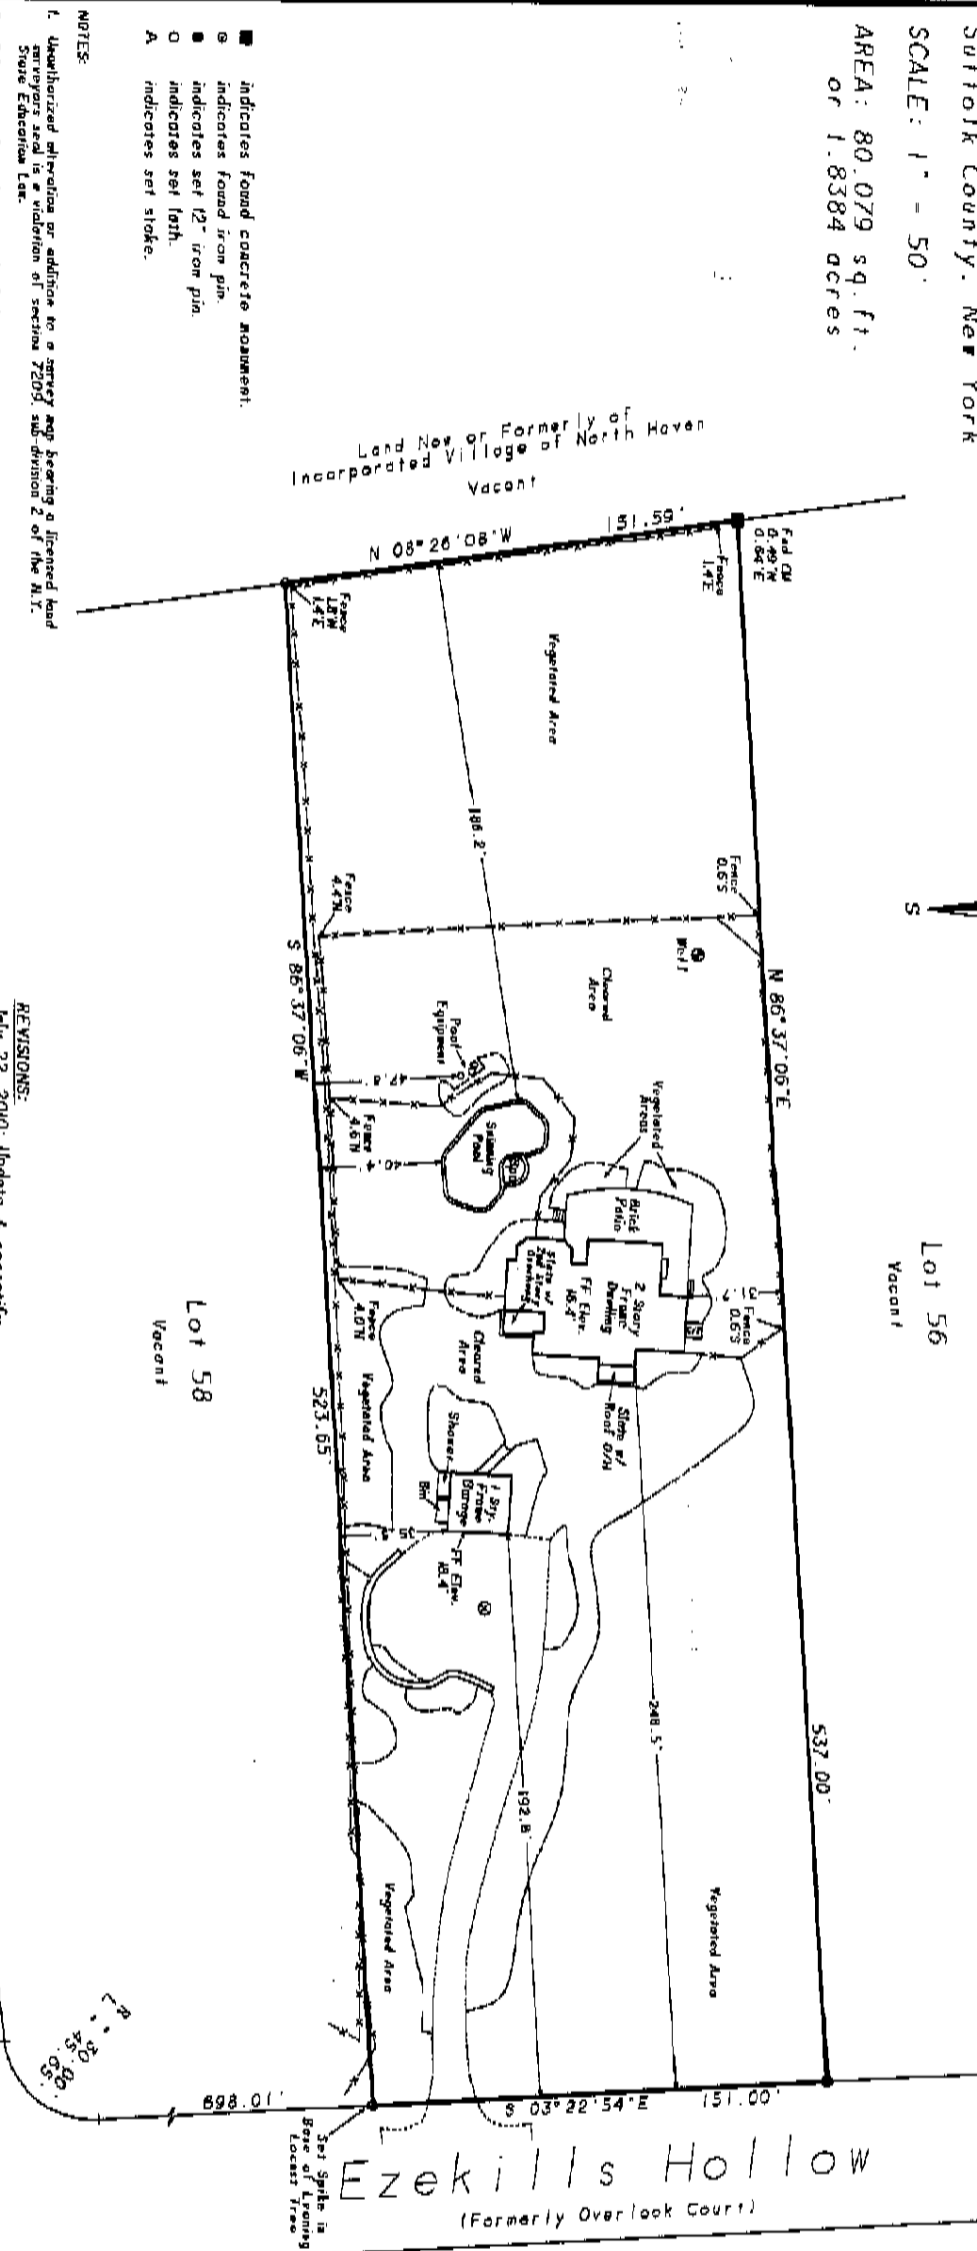

- indicates found concrete monument.
- indicates found iron pin.
- indicates set 12" iron pin.
- indicates set 1/8".
- A indicates set stake.

NOTES:

1. Unauthorized alteration or addition to a survey map bearing a licensed land surveyor's seal is a violation of section 7209, sub-division 2 of the N.Y. State Education Law.
2. Only copies from the original of this survey marked with an original of the land surveyor's embossed seal or metal seal shall be considered as the valid copies.
3. Certifications indicated hereon signify that this survey was prepared in accordance with the existing Code of Practice for Land Surveyors adopted by the N.Y. State Association of Professional Land Surveyors. Said certifications shall run only to the person for whom the survey is prepared, and on his behalf to the title company, governmental agency and lending institution listed hereon, and to the assignees of the lending institution. Certifications are not transferable to additional assignees or subsequent owners.
4. Underground improvements or encroachments, if any, are not shown hereon.
5. The existence of right of ways, wetlands and/or easements of record, if any, are shown on the plat hereon.
6. Elevations shown are from USCG & GS datum.

REVISIONS:

- July 22, 2010: Update & re-certify.
- April 28, 2005: Stake pool envelope.
- December 17, 2003: Revise proposed pool, additions & revieg.
- December 15, 2003: Proposed pool, additions & revieg.
- October 9, 2003: Re-certify.
- April 22, 2003: Revise proposed pool.
- June 12, 2000: Revise pool.
- May 9, 2000: 10' contour, proposed pool, revieg.
- March 1, 2000: Update.
- March 15, 2000: Stake p/o pool envelope.
- November 16, 1998: Under Construction.
- November 13, 1998: Add certifications.
- August 15, 1998: Stake house & garage.
- June 22, 1998: Proposed patio.
- May 14, 1998: Topography.
- May 14, 1998: Proposed Site Plan.
- May 14, 1998: Proposed site plan - 01252010 - 01252101 - 01252102 - 01252103 