

7-973-B3301

OCEAN ROAD

R. 25.00.
L. 39.27.

27°09.30"E 123.88.

R. 410.00' L. 193.63'

N 47.69'

N 13° 18' 00" W

47.00' E


160.00'

S 13° 18' 00" E


250.00'

250.00'

MEADOWLARK

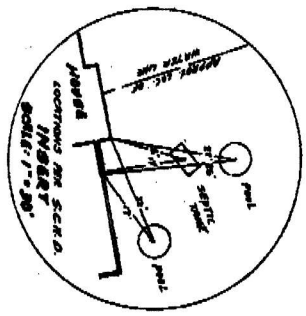

LANE

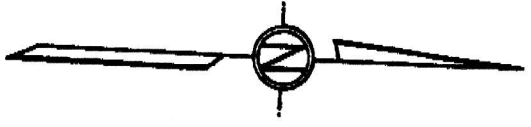


SUFFOLK COUNTY TAX MAP
 DISTRICT: 0900
 SECTION: 19400
 BLOCK: 05.00
 PARCEL: 018.000

MAP OF LOT No. 28
 SUBDIVISION MAP OF
 SAGE BRIDGEHAMPTON CORP.
 SECTION 1
 MAP No. 4949 - FILED: OCT. 14, 1967


TITLESERV
 RANERD TO:
 CAGO TITLE INS. CO.
 IN ACCORDANCE WITH THE MINIMUM
 STANDARDS FOR TITLE SURVEYS OF
 N.Y. STATE LAND TITLE ASSOC.
 16 ISLAND SAVINGS BANK

BRIDGEHAMPTON
 TOWN OF SOUTHAMPTON - 631-2675740

0.916 ACRES
 40,800 SQ. FT.

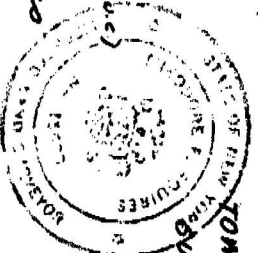

Jan. 19. 2010 1:07PM
 SURVEYED: JUNE 7, 1977
 DATED: JAN. 12, 1980 (C.C.)
 DATED: JUNE 14, 1980 (Final) (Final C.C.)
 CIRCLES & HOLDEN'S
 WEINBERGER
 Hudson, Squitro
 EDODRE F. SQUIRES
 C. LAND SURVEYOR No. 15683

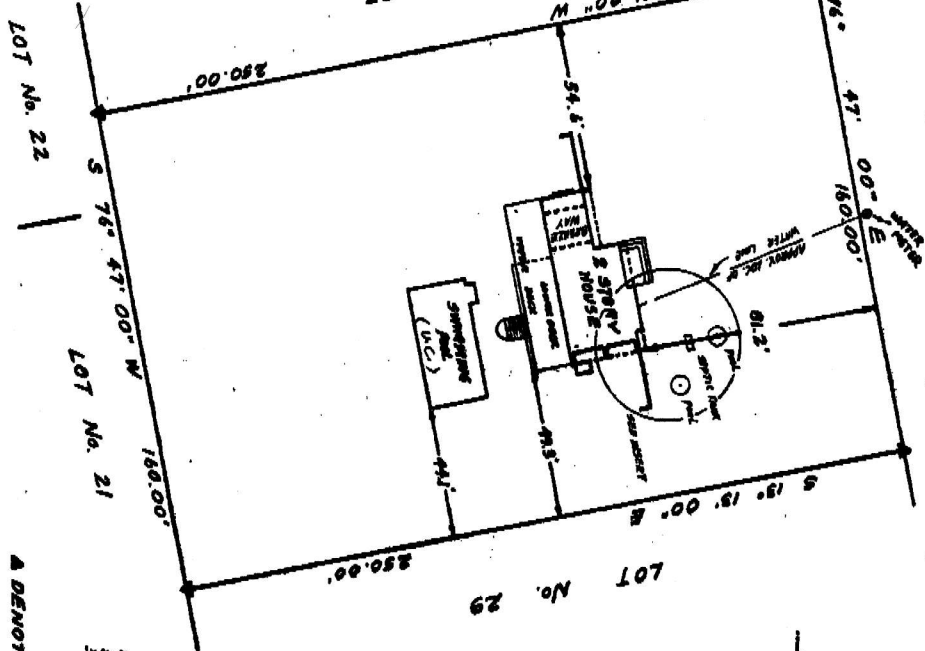

SCALE: 1" = 30'

BOOK ~ PAGE
 373 55
 373 123,498

▲ DENOTES STAKE