


CERTIFIED TO: ANDREW SILBERSTEIN

JOB NO. 2008-131  
 MAP NO. 8170  
 FILED: AUGUST 12, 1986  
 REVISIONS:

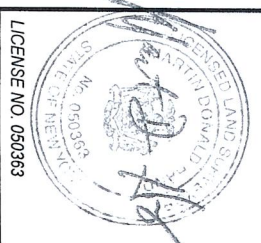




**HANDS ON SURVEYING**  
 26 SILVER BROOK DRIVE  
 FLANDERS NEW YORK  
 11901  
 TEL: (631)-369-8312 - FAX: (631)-369-8313  
 MARTIN D. HANDL, S.



**LAND SURVEYING**  

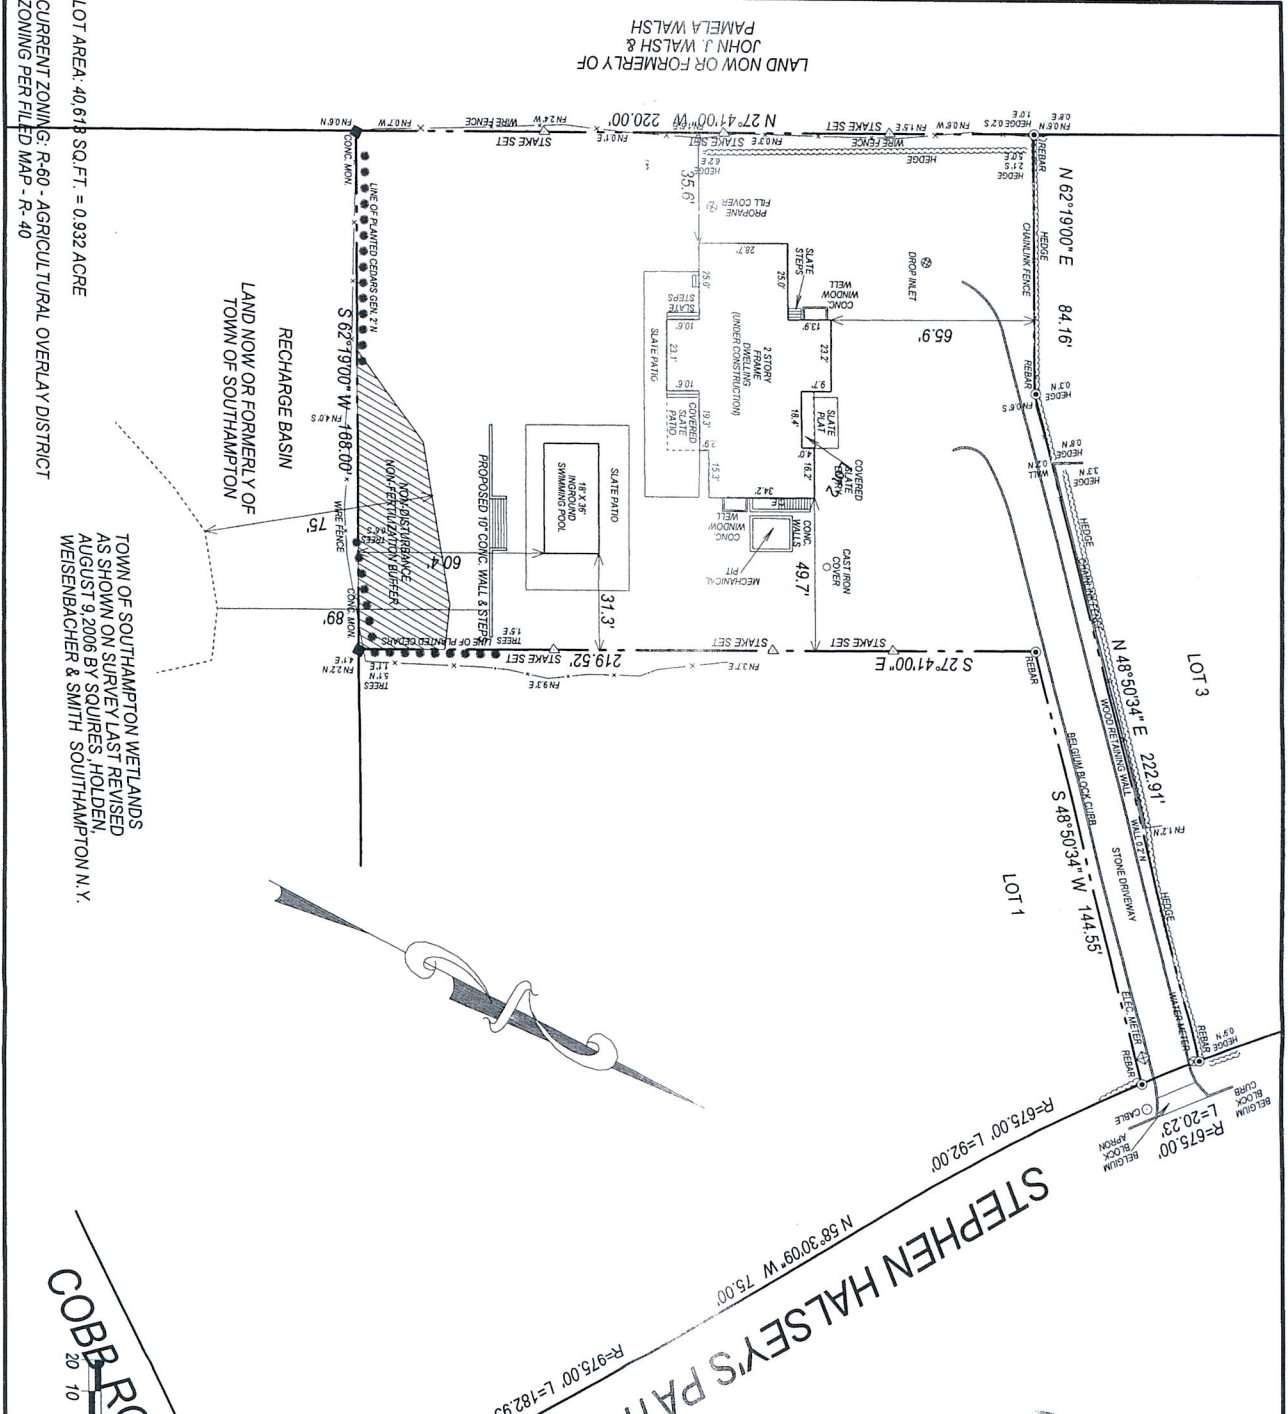

**COBB ROAD**

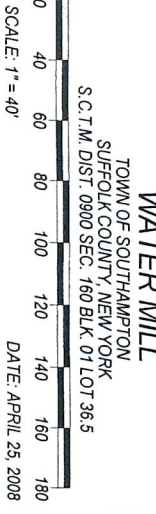

**SURVEY OF**  
**LOT 2**  
**MAP OF**  
**CHARLTON HALSEY**  
**SECTION ONE**  
**SITUATE AT**  
**WATER MILL**

TOWN OF SOUTHAMPTON  
 SUFFOLK COUNTY, NEW YORK  

DATE: APRIL 25, 2008

LOT AREA: 40,618 SQ. FT. = 0.932 ACRE  
 CURRENT ZONING: R-60 - AGRICULTURAL OVERLAY DISTRICT  
 ZONING PER FILED MAP - R-40

LAND NOW OR FORMERLY OF  
 JOHN J. WALSH &  
 PAMELA WALSH