

LOT-35 HAMPTON WATERS SEC-1


Filed Feb 25, 1958 Map No 2799
situate

Three Mile Harbor Town of East Hampton
Suffolk County, N.Y.

SCALE 1" = 40'

AREA = 21,532 Sq. Ft. or 0.494 Acre to Tie Line

Note:
The existence of right of ways and/or
easements of record if any not shown
are not guaranteed.
Datum: U.S.C. & G.S.

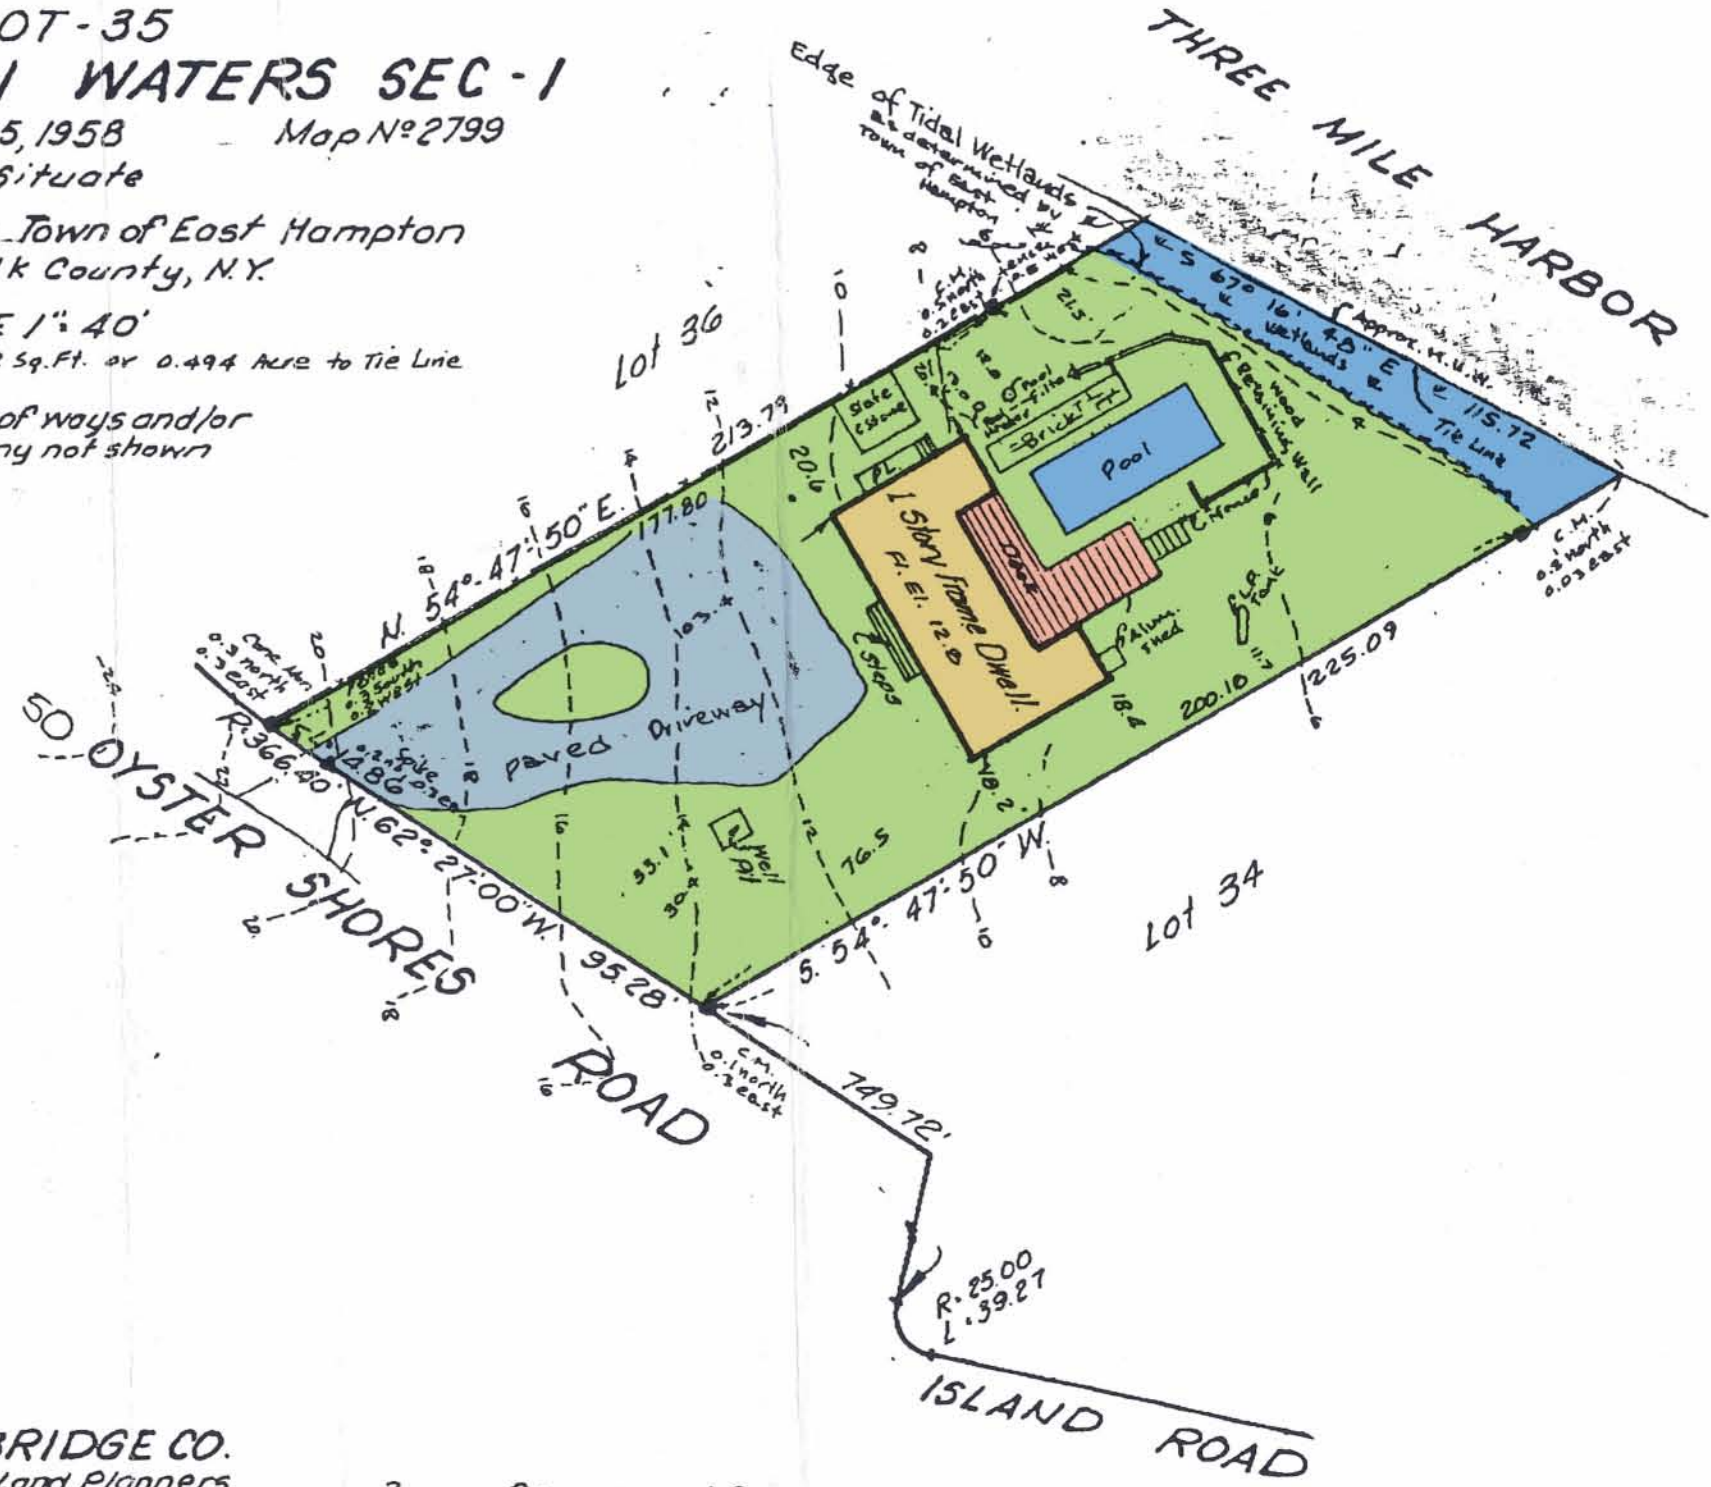

GEORGE H. WALBRIDGE CO.
Land Surveyors and Land Planners
East Hampton, N.Y.

300-92-10-19

P.02
5165375744

Nov-13-97 09:40A Alan I. Sosne, Esq.