

SURVEY OF PROPERTY

CTM No. 301-012-6-5

119p68


Situate
INCORPORATED VILLAGE OF EAST HAMPTON
Town Of East Hampton
Suffolk County, New York

SCALE: 1" = 40'


AREA: 51,246 sq.ft.
or 1.1764 acres

Certified only to:

Herbert Sambol
First American Title Insurance
Company of New York

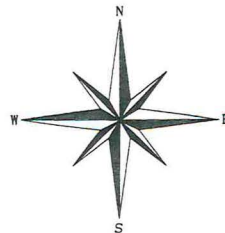

Edge of Foreman
La Forest Lane

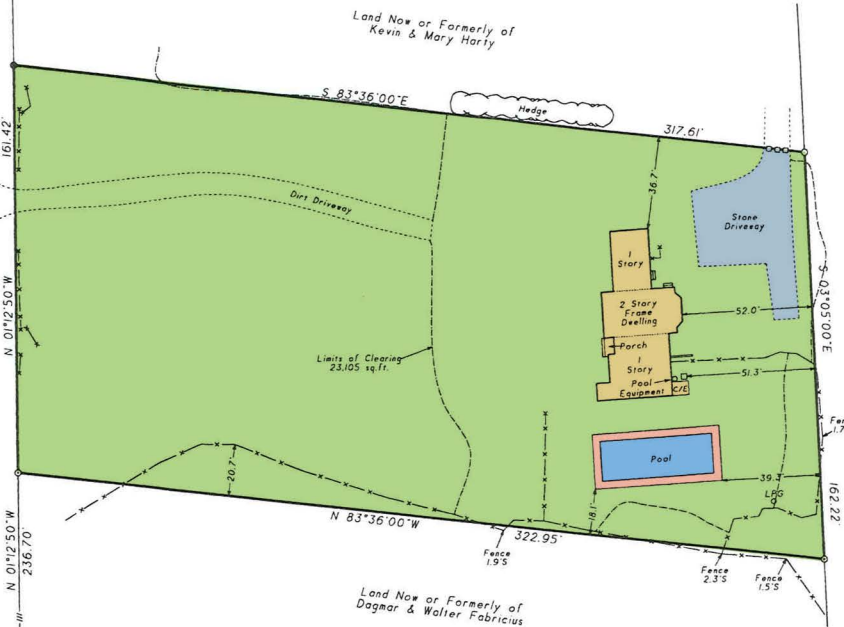

Land Now or Formerly of
Cynthia & Charles W. McCracken

- indicates found metal fence post.
- indicates found iron rod.
- indicates found iron pin.
- indicates set 12" iron pin.

- NOTES:
- Unauthorized alteration or addition to a survey map bearing a licensed land surveyors seal is a violation of section 7209, sub-division 2 of the N.Y. State Education Law.
 - Only copies from the original of this survey marked with an original of the land surveyor's embossed seal or inked seal shall be considered to be valid copies.
 - Certifications indicated hereon signify that this survey was prepared in accordance with the existing Code of Practice for Land Surveys adopted by the N.Y. State Association of Professional Land Surveyors. Said certifications shall run only to the person for whom the survey is prepared, and on his behalf to the Title company, governmental agency and Lending institution listed hereon, and to the assignees of the lending institution. Certifications are not transferable to additional institutions or subsequent owners.
 - Underground improvements or encroachments, if any, are not shown hereon.
 - The existence of right of ways, wetlands and/or easements of record, if any, not shown are not guaranteed.
 - All natural features shown on survey, including but not limited to Bluff Crest, Clearing, and Wetlands should be verified with the appropriate regulatory agency.
 - Elevations shown are based on assumed datum.
 - Elevations shown hereon are for purposes of compliance with the requirements of the Suffolk County Department of Health Services and should not be used for any other purposes.

Apaquogue Road

Not a valid copy unless marked
with original land surveyor's
embossed seal & signature



Surveyed: July 28, 2006
David L. Saskas
N. Y. S. Lic. No. 049960
Saskas Surveying Company, P.C.
124 Cedar Street
East Hampton, New York 11937
(631) 324-6917 FAX 329-4768