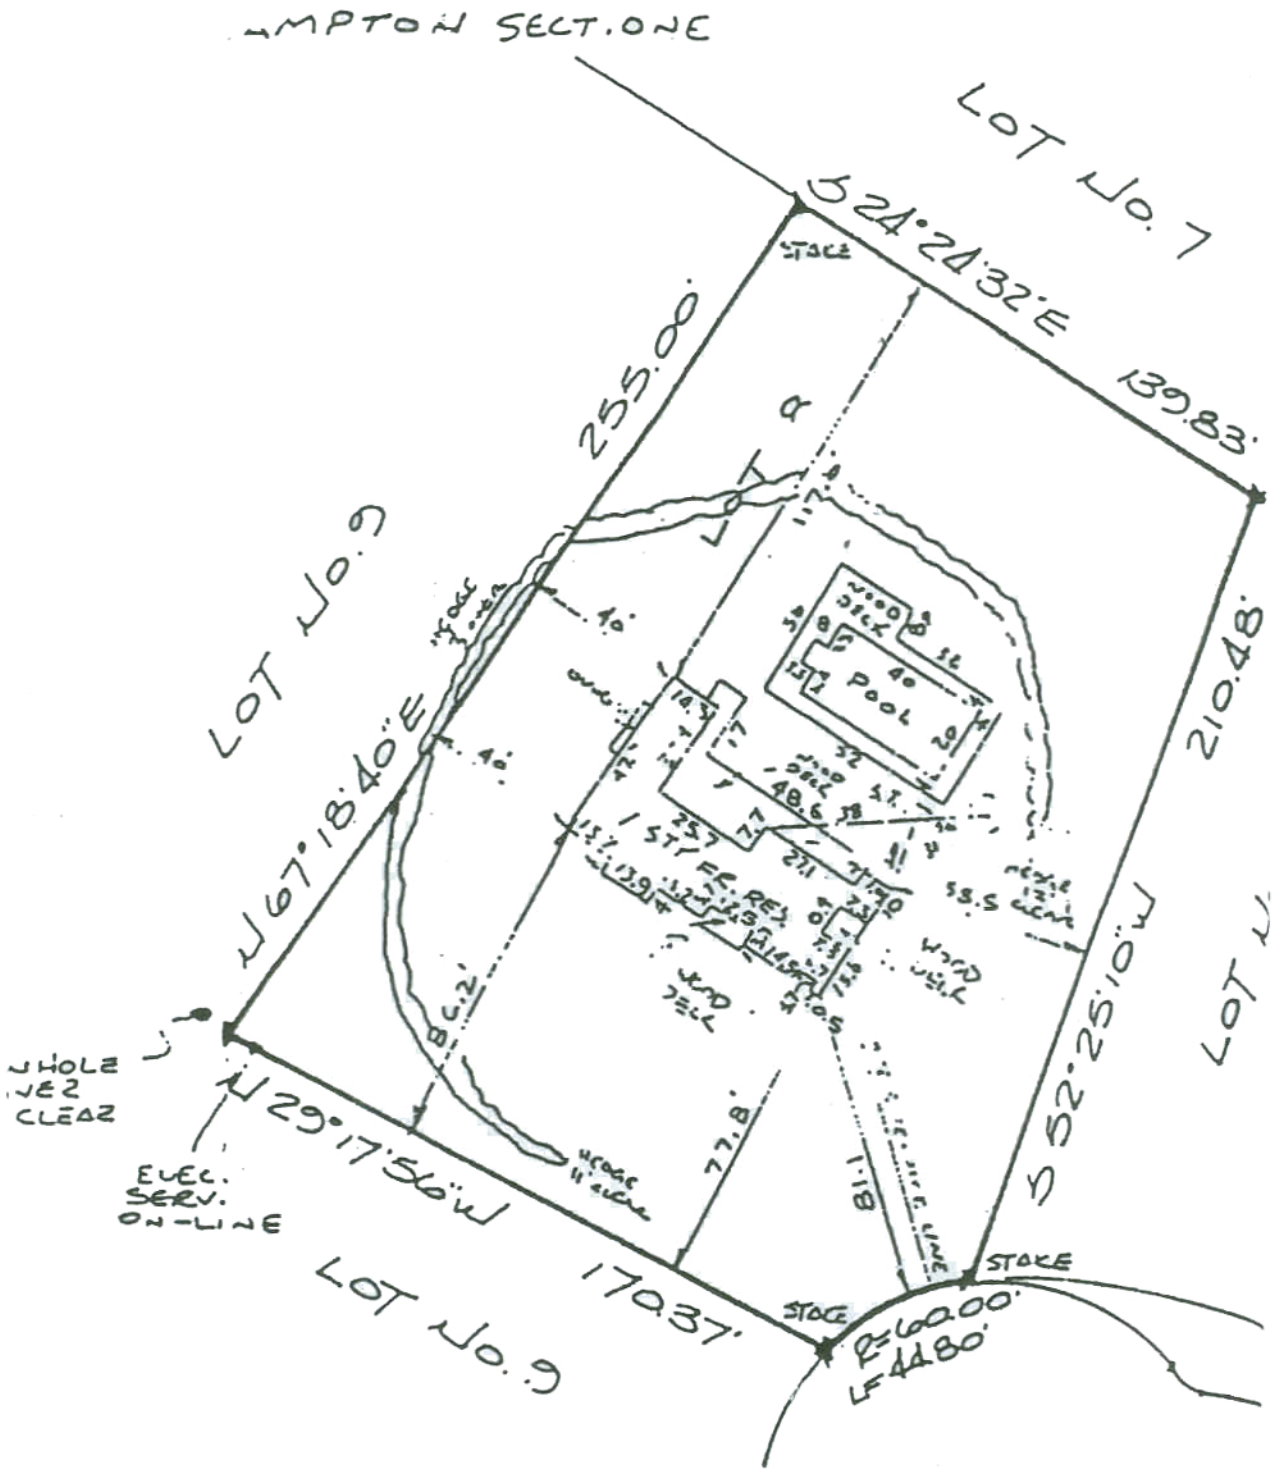
LOT No. 7
S 24°24'32"E
139.83'
255.00'
LOT No. 9
N 67°18'40"E
210.48'
S 52°25'10"W
LOT No. 9
N 29°17'50"W
170.37'
LOT No. 9
STAKE
STAKE
STAKE
R=60.00'
L=44.80'
Pool
40
29
48.6
77.8'
118'
EVEL. SERV. ON-LINE