SURVEYED FOR: HARDING & JANICE WILLINGER
PROPERTY LOCATED AT BRIDGEHAMPTON
LOT No. 1
MAP OF BRICK HILL
FILED: MARCH 6, 1997; FILE No. 9976
TOWN OF SOUTHAMPTON
SUFFOLK COUNTY, NEW YORK
S.C.T.M. # 900-036-01-14.4
AREA = 47,044 SF. = 1.0800 ACRES
SCALE: 1"=50'

NOTE: THE EXISTENCE OF RIGHT OF WAYS, WETLANDS AND/OR EASEMENTS OF RECORD IF ANY, NOT SHOWN ARE NOT GUARANTEED.

CLEARING CALCULATIONS:

LOT AREA = 47,044 SF.
MAXIMUM ALLOWABLE CLEARING = 23,522 SF. = 50.0%
EXISTING LOT CLEARING = 23,500 SF. = 50%

NOTE: WELL AND SEPTIC SYSTEM LOCATION BY OTHERS. S.C.H. REF. No.

SEPTIC LOCATION

	'A'	'B'	'C'	'D'
S.T.	42'	18'		
L.P.	46'	27.5'		
WELL			87.8'	78.4'

CERTIFIED TO:
HARDING WILLINGER
JANICE WILLINGER
CITIMORTGAGE INC.
COMMONWEALTH LAND TITLE INS. CO.

STATE OF NEW YORK
JOHN P. BARYLSKI
LS 49376
LICENSED LAND SURVEYOR

UNAUTHORIZED ALTERATION OR ADDITION TO THIS SURVEY IS A VIOLATION OF SECTION 7209 OF THE NEW YORK STATE EDUCATION LAW.

COPIES OF THIS SURVEY MAP NOT BEARING THE LAND SURVEYORS INKED OR EMBOSSED SEAL SHALL NOT BE CONSIDERED TO BE A VALID TRUE COPY.

GUARANTEES OR CERTIFICATIONS INDICATED HEREON SHALL RUN ONLY TO THE PERSON FOR WHOM THE SURVEY IS PREPARED, AND ON HIS BEHALF TO THE TITLE COMPANY, GOVERNMENTAL AGENCY AND LENDING INSTITUTION LISTED HEREON, AND TO THE ASSIGNEES OF THE LENDING INSTITUTION. GUARANTEES OR CERTIFICATIONS ARE NOT TRANSFERABLE TO ADDITIONAL INSTITUTIONS OR SUBSEQUENT OWNERS.

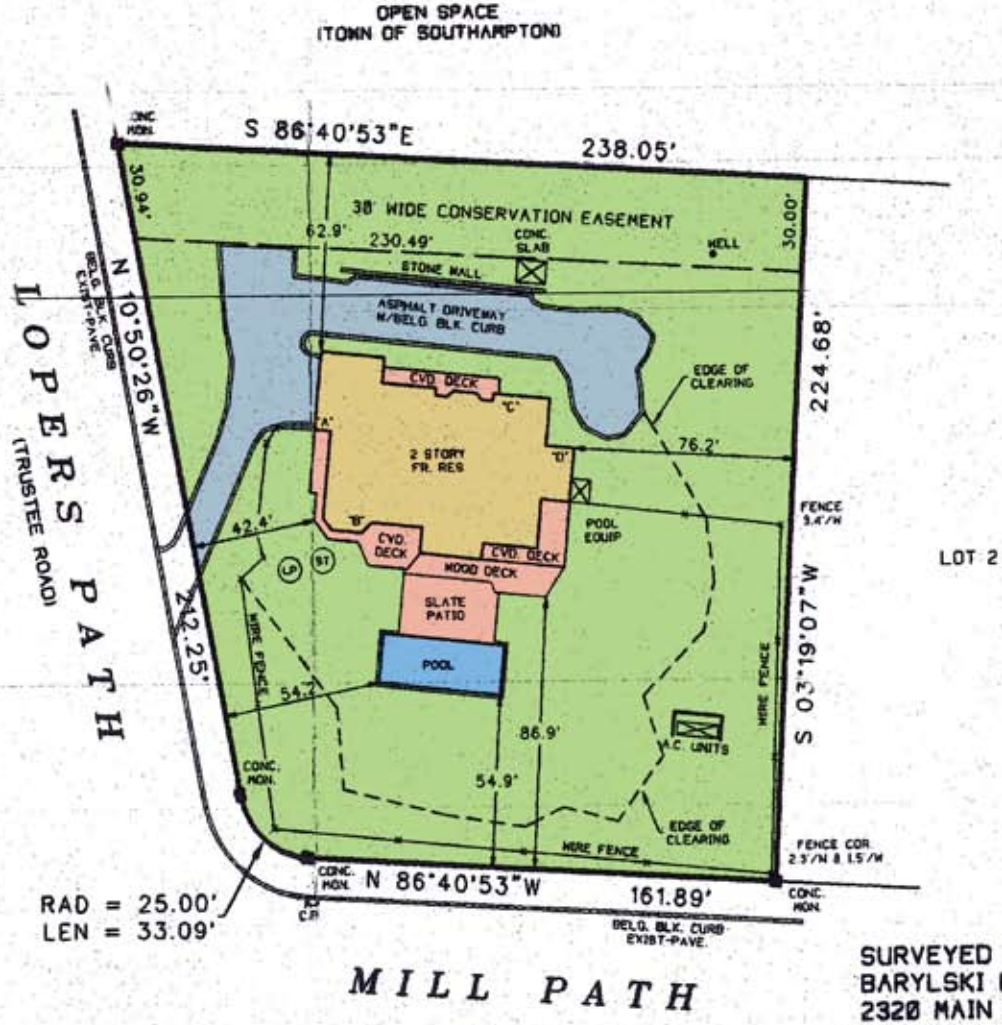

SURVEYED BY:
BARYLSKI LAND SURVEYING
2320 MAIN ST. P.O. BOX 1302
NEWMAN VILLAGE CONDO.
BRIDGEHAMPTON, NEW YORK
JUNE 25, 2001

6-13-2002: FINAL SURVEY

05/13/2008 14:11 FAX 5618482728 Willinger 002