


R-20

Acres = 520 sq. ft.
15 ft. setback

Strictly - GARAGE ONLY TO 5 FT. SETBACK
Max House = 4020 sq. ft.
Pyramid Law Applies

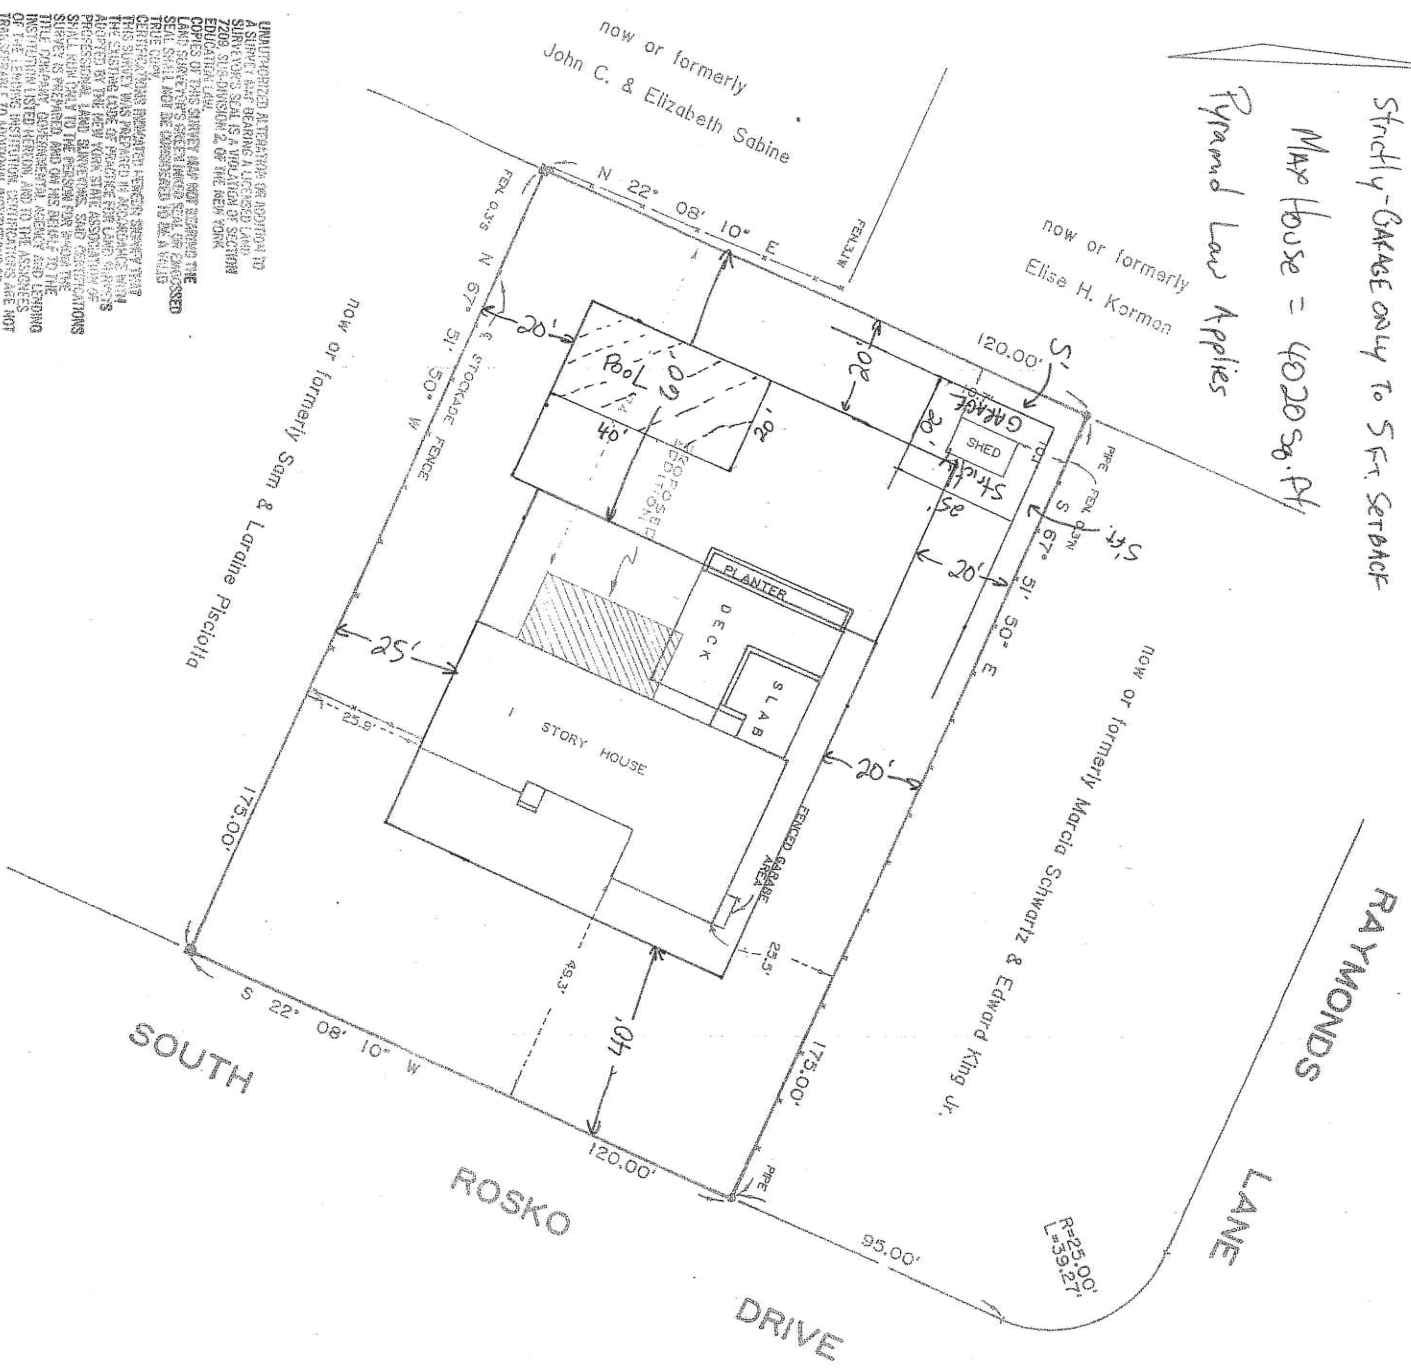



NOTE: PARCEL APPEARS AS LOT NO. 1 ON THE SUBDIVISION MAP OF ROSKO PLACE FILED IN THE SUFFOLK COUNTY CLERKS OFFICE ON JULY 28, 1960, AS MAP NO. 3211.

■ INDICATES MONUMENT
SUFFOLK COUNTY TAX MAP
DISTRICT 0904
SECTION 014.00
BLOCK 01.00
PARCEL 042.000

SURVEYED: OCT. 5, 1990



LESTER HOLDEN, S.U. NO. 49548
SQUIRES, HOLDEN, WEISENBACHER & SMITH
LAND SURVEYORS ENGINEERS
SOUTHAMPTON, NEW YORK

MAP OF PROPERTY
FOR
JOHN O'CONNELL
SITUATE
INC. VILLAGE OF SOUTHAMPTON
TOWN OF SOUTHAMPTON
SUFFOLK COUNTY, N.Y.
AREA = 21, 000 S.F.
SCALE 1" = 30'