
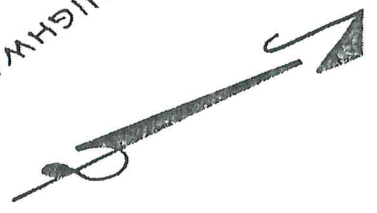


NOTE: THE EXISTENCE OF MASH
MANS, WETLANDS, AND/OR
ASSESSMENTS OF RECORD, IF
ANY, NOT SHOWN ARE NOT
GUARANTEED.

C.T.M. 0300-165-01-04

Fence along line
N 07° 04' 30" E
land now or formerly of
James L. & Marilyn Wood

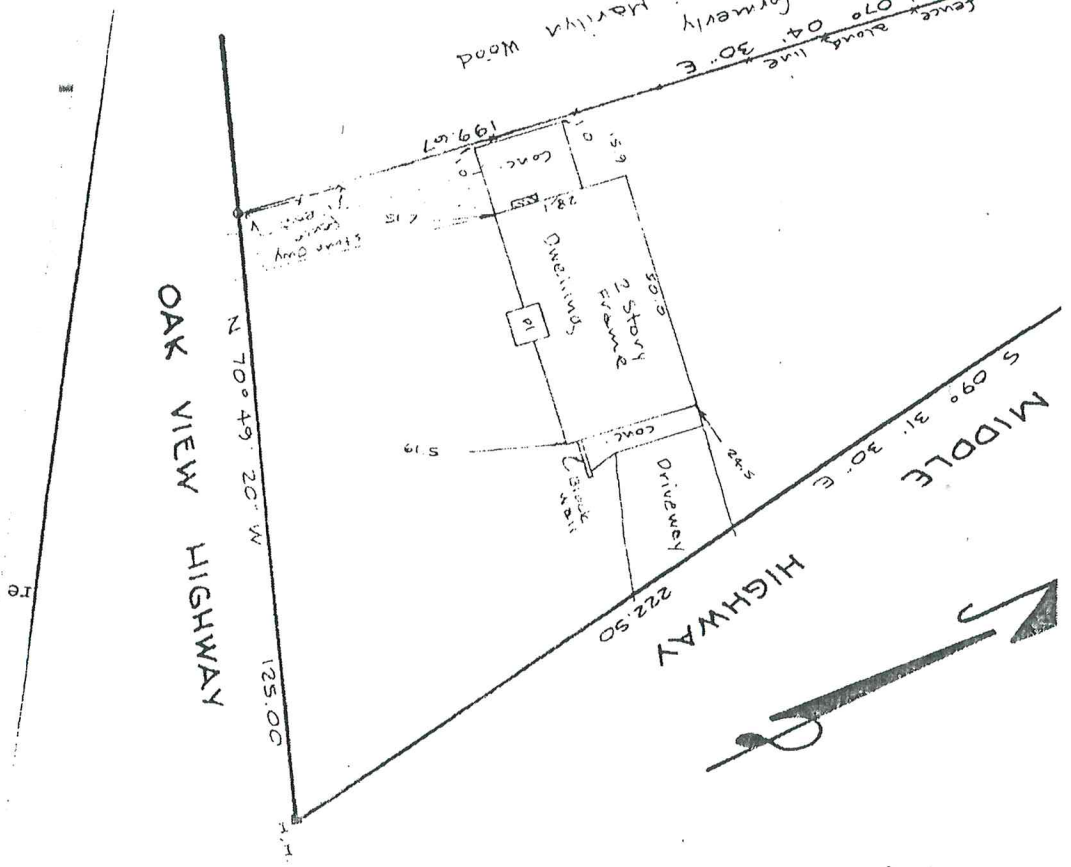

MAP OF PROPERTY
Situating
TOWN OF EAST HAMPTON
Suffolk Co., New York

Scale: 1" = 30'
Area = 18,053 Sq. Ft. or
0.414 Acres

Guaranteed to:
Robert D. Gibbons
Gail S. Gibbons
Citibank N.Y.
Title Guarantee is
#T1288-0692

Resurveyed: April 4, 1994
Revised: April 2, 1988
Surveyed: March 27, 1952

GEORGE H. WALBRIDGE

Land Surveyors & Land Planners
East Hampton, Long Island, N.Y.

CORCORAN
corcoran group real estate

Nancy Howell
Senior Vice President
Associate Broker

nancy.howell@corcoran.com
51 Main Street
East Hampton, NY 11937
d: 631.907.1503
f: 631.614.3933
m: 631.875.2049