


LOT 2 MINOR SUBDIVISION SANTANIELLO

SITUATE
AMAGANSETT

East Hampton, Suffolk Co., N.Y.
Scale: 1"=50'
Area: 40,000 S.F. or 0.918 Acres
Zoning: A Residence
Flood Zone: X
Fire District: Amagansett
School District: Amagansett

Certified To:
John Santaniello

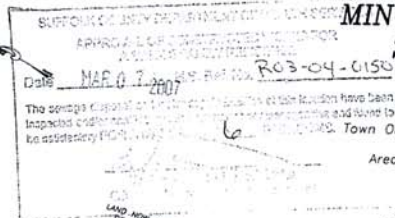

NOTE:

- Unauthorized alteration or addition to a survey map bearing a licensed surveyor's seal is a violation of section 7200 of the New York State Education Law.
- Only copies from the original of this survey map bearing an original land surveyor's inked seal or embossed seal shall be considered to be a valid copy.
- Certifications indicated hereon shall run only to the person for whom the survey is prepared, and on his/her behalf to the site company, governmental agency and land subdivision listed hereon. Certifications are not transferable to additional institutions or subsequent owners. Certifications indicated hereon signify that this survey was prepared in accordance with the existing code of practice for land surveys adopted by the New York State Association of Professional Land Surveyors.
- The existence of subsurface improvements or encroachments, or relations, or easements, covenants, or restrictions of record, if any, not shown are not certified.

Datum U.S.C.&G.S.
S.C.T.M. 0300-150-05-13.2

2.0'	Dark Brown Loam SS
6.0'	Brown Silty Sand SM
17.0'	Brown And Pale Brown Fine to Course Sand SW

TEST HOLE #2
12/11/03
McDonald Geoscience

4.0'	Sand SM
17.0'	Brown Fine to Course Sand SW

TEST HOLE #1
12/11/03
McDonald Geoscience

CLEARING
ALLOWED - 23,000 SF
EXISTING - 23,791 SF

NOTE:
- THE LOCATION OF SEWAGE
DISPOSAL SYSTEM PER INSTALLER

Revised: Feb. 27, 2007 - Water Line, Driveway & Sani
Revised: Feb. 13, 2007 - Pool Hse. Sani.
Revised: Dec. 19, 2006 - Final
Revised: April 28, 2005 - LPA Eose.
Revised: April 5, 2005 - Eose. Bearings
Revised: Mar. 3, 2005 - Cobana Relocation
Map Prepared: Feb. 24, 2005
Surveyed: June 11, 2003

GEORGE WALBRIDGE SURVEYORS, P.C.
Land Surveyors & Land Planners
300 Pantigo Place - Suite 116
East Hampton, Long Island, N.Y. 11957
Phone: (631) 324-0412 Fax: (631) 324-9849
E-mail: ehsurveyor@aol.com