

MESA
MESA

N/O/T TARONE
BY J. TARONE

N 22°08'10" W 48.25'

S 59°02'10" W 57.15'

N/O/R GELINAS
& LINDA J. SOSNOWITZ

R=60.00'

N 12°14'45" E


99.02'

L=116.78'

66.10'

N 69°31'00" E

N/O/T
CELESTINO GABRI

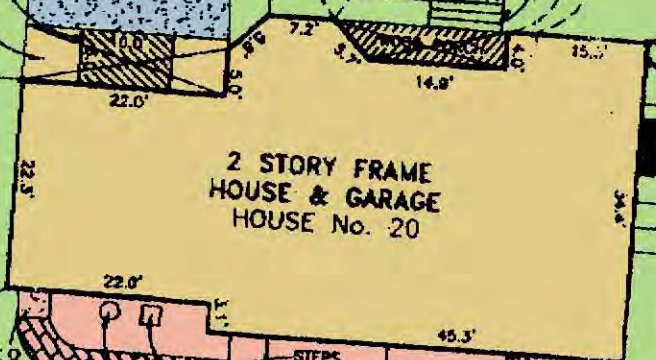

2 STORY FRAME
HOUSE & GARAGE
HOUSE No. 20

STEPS

INDOOR POOL

N/O/R
WALTER PAREPELE

159.03'

14.48'40" E

PRINTED