


ATLANTIC AVENUE (OCEAN ROAD)

N 13°50'30"E 160.00'

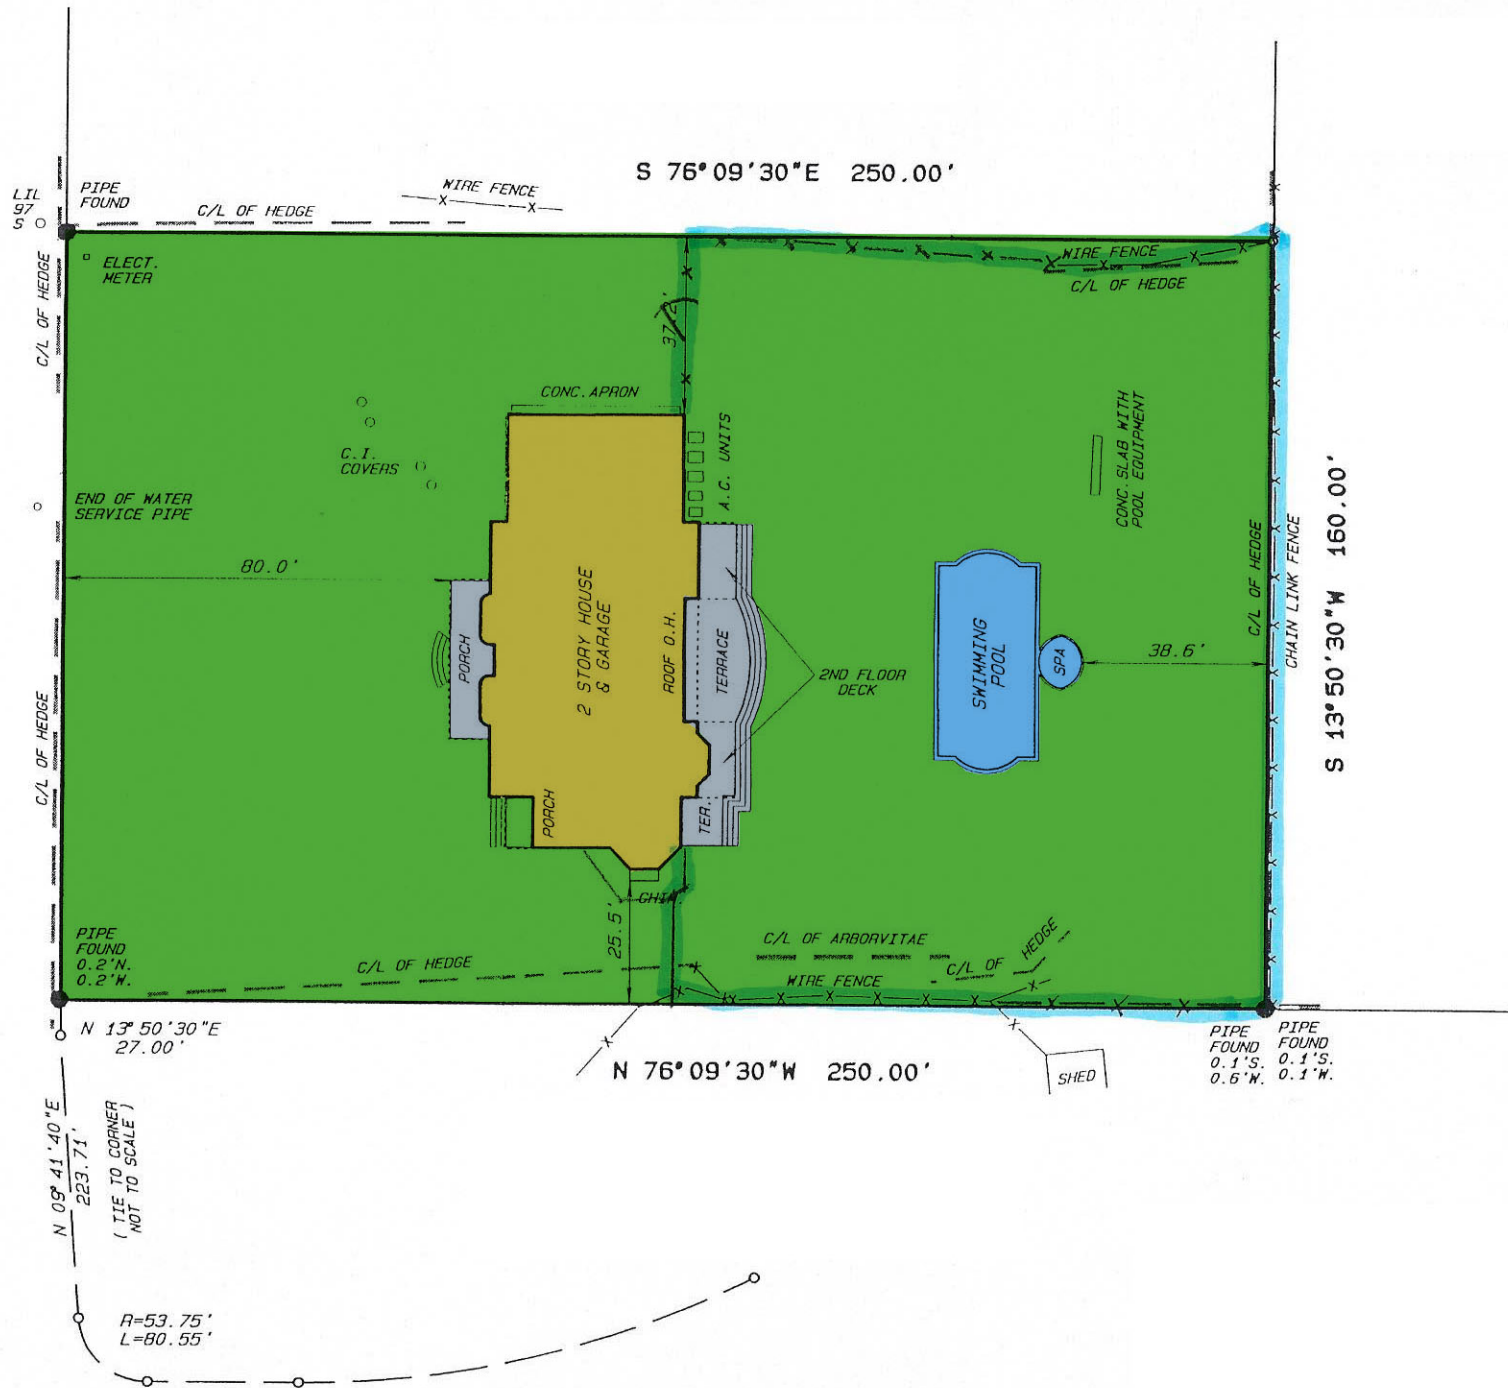

S 76°09'30"E 250.00'

L.I.L. 97 S 0

C/L OF HEDGE

PIPE FOUND C/L OF HEDGE

ELECT. METER

END OF WATER SERVICE PIPE

80.0'

C/L OF HEDGE

PIPE FOUND 0.2' N. 0.2' W.

N 09°41'40"E 223.71'

(TIE TO CORNER NOT TO SCALE)

R=53.75' L=80.55'

N 13°50'30"E 27.00'

N 76°09'30"W 250.00'

SHED

PIPE FOUND 0.1'S. 0.6'W. PIPE FOUND 0.1'S. 0.1'W.

S 13°50'30"W 160.00'

SURFSIDE DRIVE

