


CLEARED AREA = 15,618 sq. ft. = 44.6%  
(45% PERMITTED)

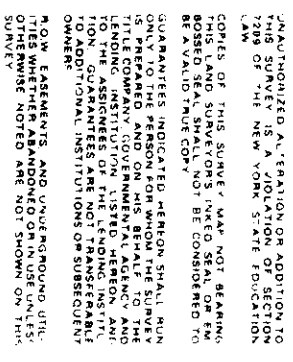

JACOB M. BUCHHEI  
LICENSE NO. 47400

WILLIAM G. LOWE  
LICENSE NO. 49476


**DOLLIVER LAND SURVEYING, PC**  
LAND SURVEYORS AND PLANNERS  
HAMPTON BAYS, NEW YORK

PREPARED 8-12-14 SURVEYED Aug 7, 2014  
SCALE 1" = 40 ■ DENOTES MONUMENTS

**Δ DENOTES STAKES**

BK 245 PG 87

CLEANUP AREA: 229394.5 = 69%

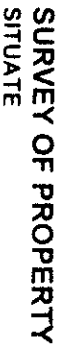

CERTIFIED TO:  
29 PAYNE AVE LLC,

**DOLLIVER LAND SURVEYING, PC**  
LAND SURVEYORS AND PLANNERS  
HAMPTON BAYS, NEW YORK