- A5233

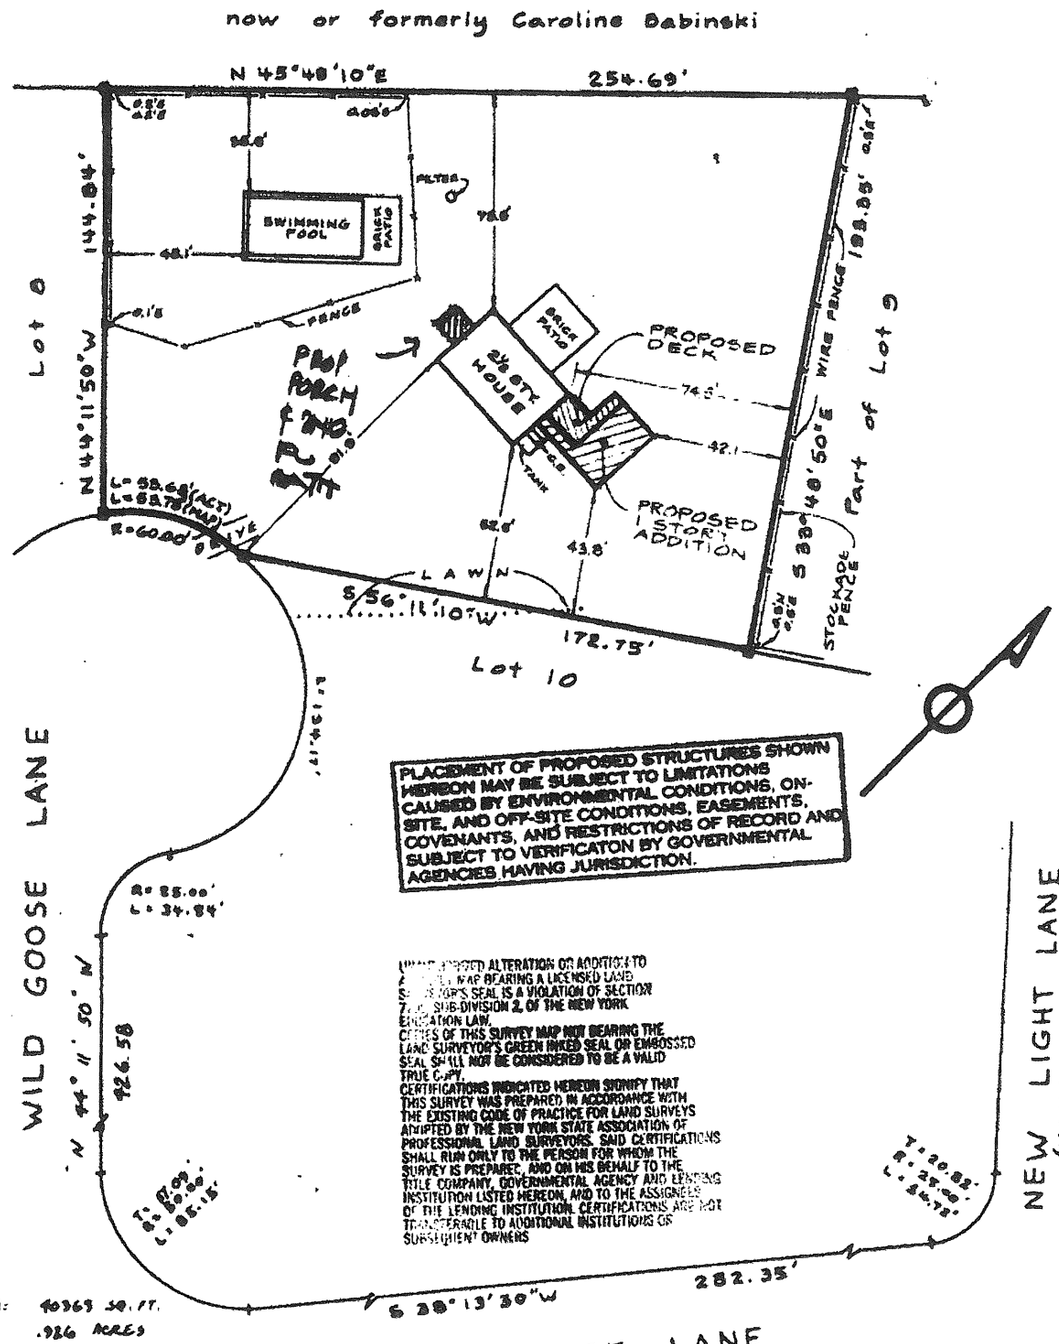

AREA: 40369 SQ. FT.
.926 ACRES

SURVEYED: JUNE 23, 1983
REVISED: JUNE 13, 1996 (loc. pool)

CERTIFIED TO:
THE TITLE GUARANTEE CO.
JEFFREY S. WHITE AND
HILDA SHAMASH

SUFFOLK COUNTY TAX MAP

DISTRICT	0900
SECTION	103
BLOCK	2
PARCEL	27

ROBERT A. SMITH
SQUIRES, HOLDE[illegible]
WEISENBACHER [illegible]
LAND SURVEYORS -
SOUTHAMPTON, N.Y.

MAP OF PART OF LOT 9
SUBDIVISION MAP OF HAYGROUND ACRES
MAP NO. 9502 - FILED JULY 27, 1970

SITUATE
HAYGROUND
TOWN OF SOUTHAMPTON
SUFFOLK COUNTY, N.Y.

SCALE 1" = 50'